
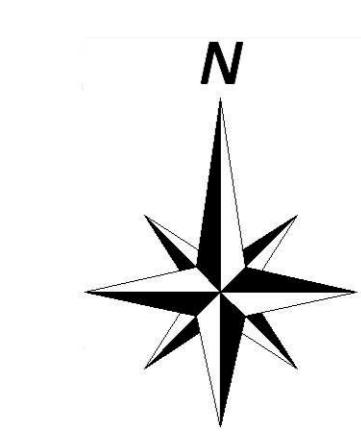


# 寝屋川市下水道台帳

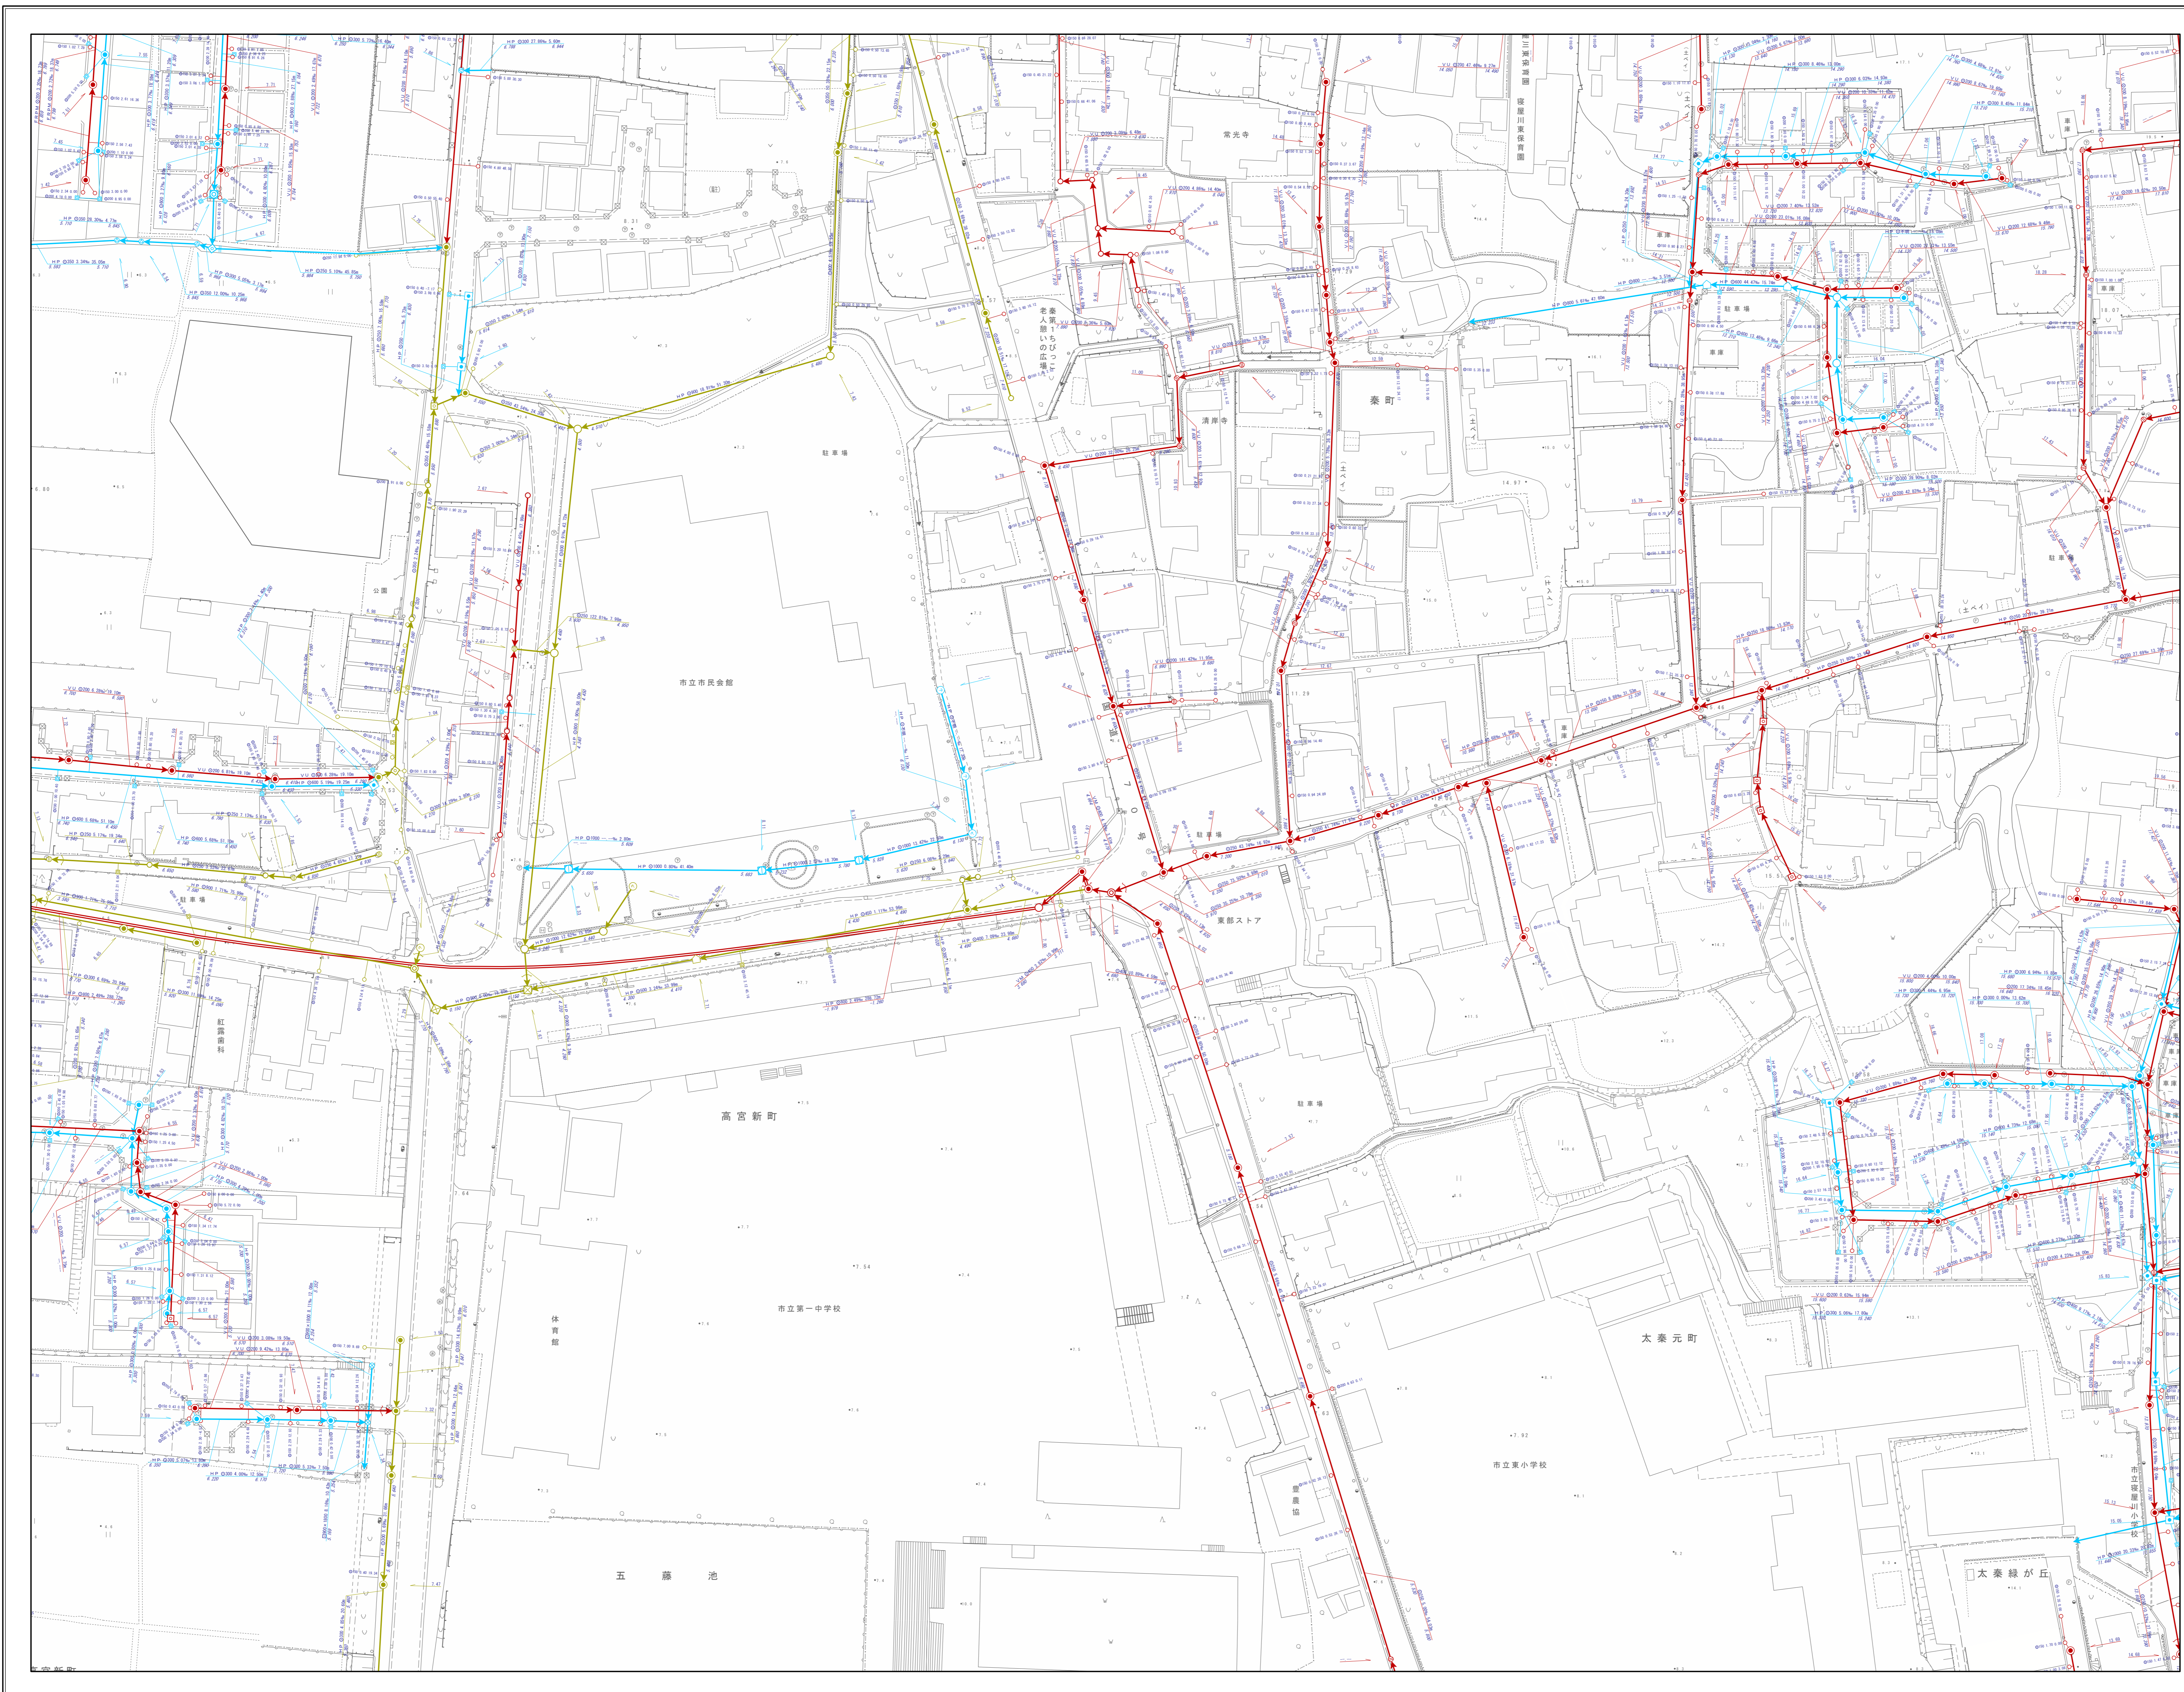

| 凡                       |                      | 例                    |                |
|-------------------------|----------------------|----------------------|----------------|
| 記号                      |                      | 名称                   |                |
| [Thick black arrow]     |                      | 流域幹線                 |                |
| [Red arrow]             |                      | 幹線管渠                 |                |
| [Thin red arrow]        |                      | 枝線管渠                 |                |
| [Red arrow]             |                      | 汚水                   |                |
| [Cyan arrow]            |                      | 雨水                   |                |
| [Yellow arrow]          |                      | 合流                   |                |
| [Red arrow with circle] |                      | 副管                   |                |
| 人 孔                     |                      |                      |                |
| [Circle with Y]         | Y号人孔                 | [Circle with 0]      | 0号人孔           |
| [Circle with 1]         | 1号人孔                 | [Circle with 1]      | 橋田人孔           |
| [Circle with 2]         | 2号人孔                 | [Small circle]       | 小口人孔           |
| [Circle with 3]         | 3号人孔                 | [Circle with 30]     | 塩ビ30人孔         |
| [Circle with 4]         | 4号人孔                 | [Circle with 45]     | コンφ45人孔        |
| [Circle with 5]         | 5号人孔                 | [Circle with L]      | レジン人孔          |
| [Circle with 6]         | 6号人孔                 | [Circle with P0]     | マンホールポンプ0号人孔   |
| [Circle with 7]         | 7号人孔                 | [Circle with P1]     | マンホールポンプ1号人孔   |
| [Circle with 1]         | 特1号人孔                | [Circle with P2]     | マンホールポンプ2号人孔   |
| [Circle with 2]         | 特2号人孔                | [Circle with P3]     | マンホールポンプ3号人孔   |
| [Circle with 3]         | 特3号人孔                | [Circle with P4]     | マンホールポンプ4号人孔   |
| [Circle with 4]         | 特4号人孔                | [Circle with P]      | マンホールポンプ特殊人孔   |
| [Square with 1]         | 矩形人孔                 | [Circle with P]      | マンホールポンプ人孔種別不明 |
| [Square with 2]         | 特殊人孔                 | [Square with P]      | ポンプ場           |
| [Square with X]         | 伏越人孔                 | [Triangle with P]    | 吐け口            |
| [Circle with 500]       | φ500特殊人孔             | [Vertical line]      | キャップ止め         |
| [Circle with 600]       | φ600特殊人孔             | [Dot]                | 吐け口            |
| [Circle with 750]       | φ750特殊人孔             | [Circle with X]      | ダミー人孔          |
| [Square with grid]      | 会所                   | [Circle with ?]      | 不明             |
| 雨 水 施 設                 |                      |                      |                |
| [Circle with H]         | 樋門                   | [Blue square]        | 調節池            |
| ま す                     |                      |                      |                |
| [Red circle]            | 汚水樹                  | [Cyan circle]        | 雨水樹            |
| [Blue square]           | 道路雨水樹                | [Red circle]         | ポンプ            |
| [Red line]              | キャップ止                | [Red circle]         | 不明             |
| 人 孔 属 性                 |                      |                      |                |
| [Circle with 111.110]   | 地盤高                  | 111.110              |                |
| 管 渠 属 性                 |                      |                      |                |
| [Diagram]               | 管断面 勾配               | 管断面 勾配               |                |
| [Diagram]               | 管種 ↓ 管径 ↓ 区間距離       | 管種 ↓ 管径 ↓ 区間距離       |                |
| [Diagram]               | VU Q200 0.48% 20.75m | VU Q200 0.48% 20.75m |                |
| [Diagram]               | 上流管底高                | 下流管底高                |                |
| [Diagram]               | 4.230                | 4.220                |                |
| [Diagram]               | 4.230                | 4.220                |                |
| [Diagram]               | 上流管底高                | 下流管底高                |                |
| 取 付 管 属 性               |                      |                      |                |
| [Diagram]               | 管断面                  | 取付管延長                |                |
| [Diagram]               | 100 4.29             | 10.84                |                |
| [Diagram]               | 管径                   | 上流側人孔からの距離           |                |