
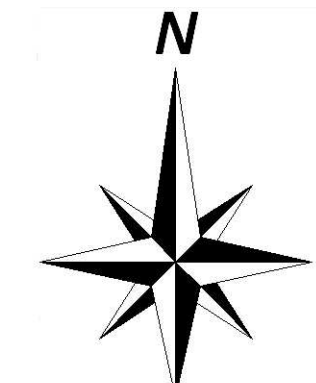


寝屋川市下水道台帳

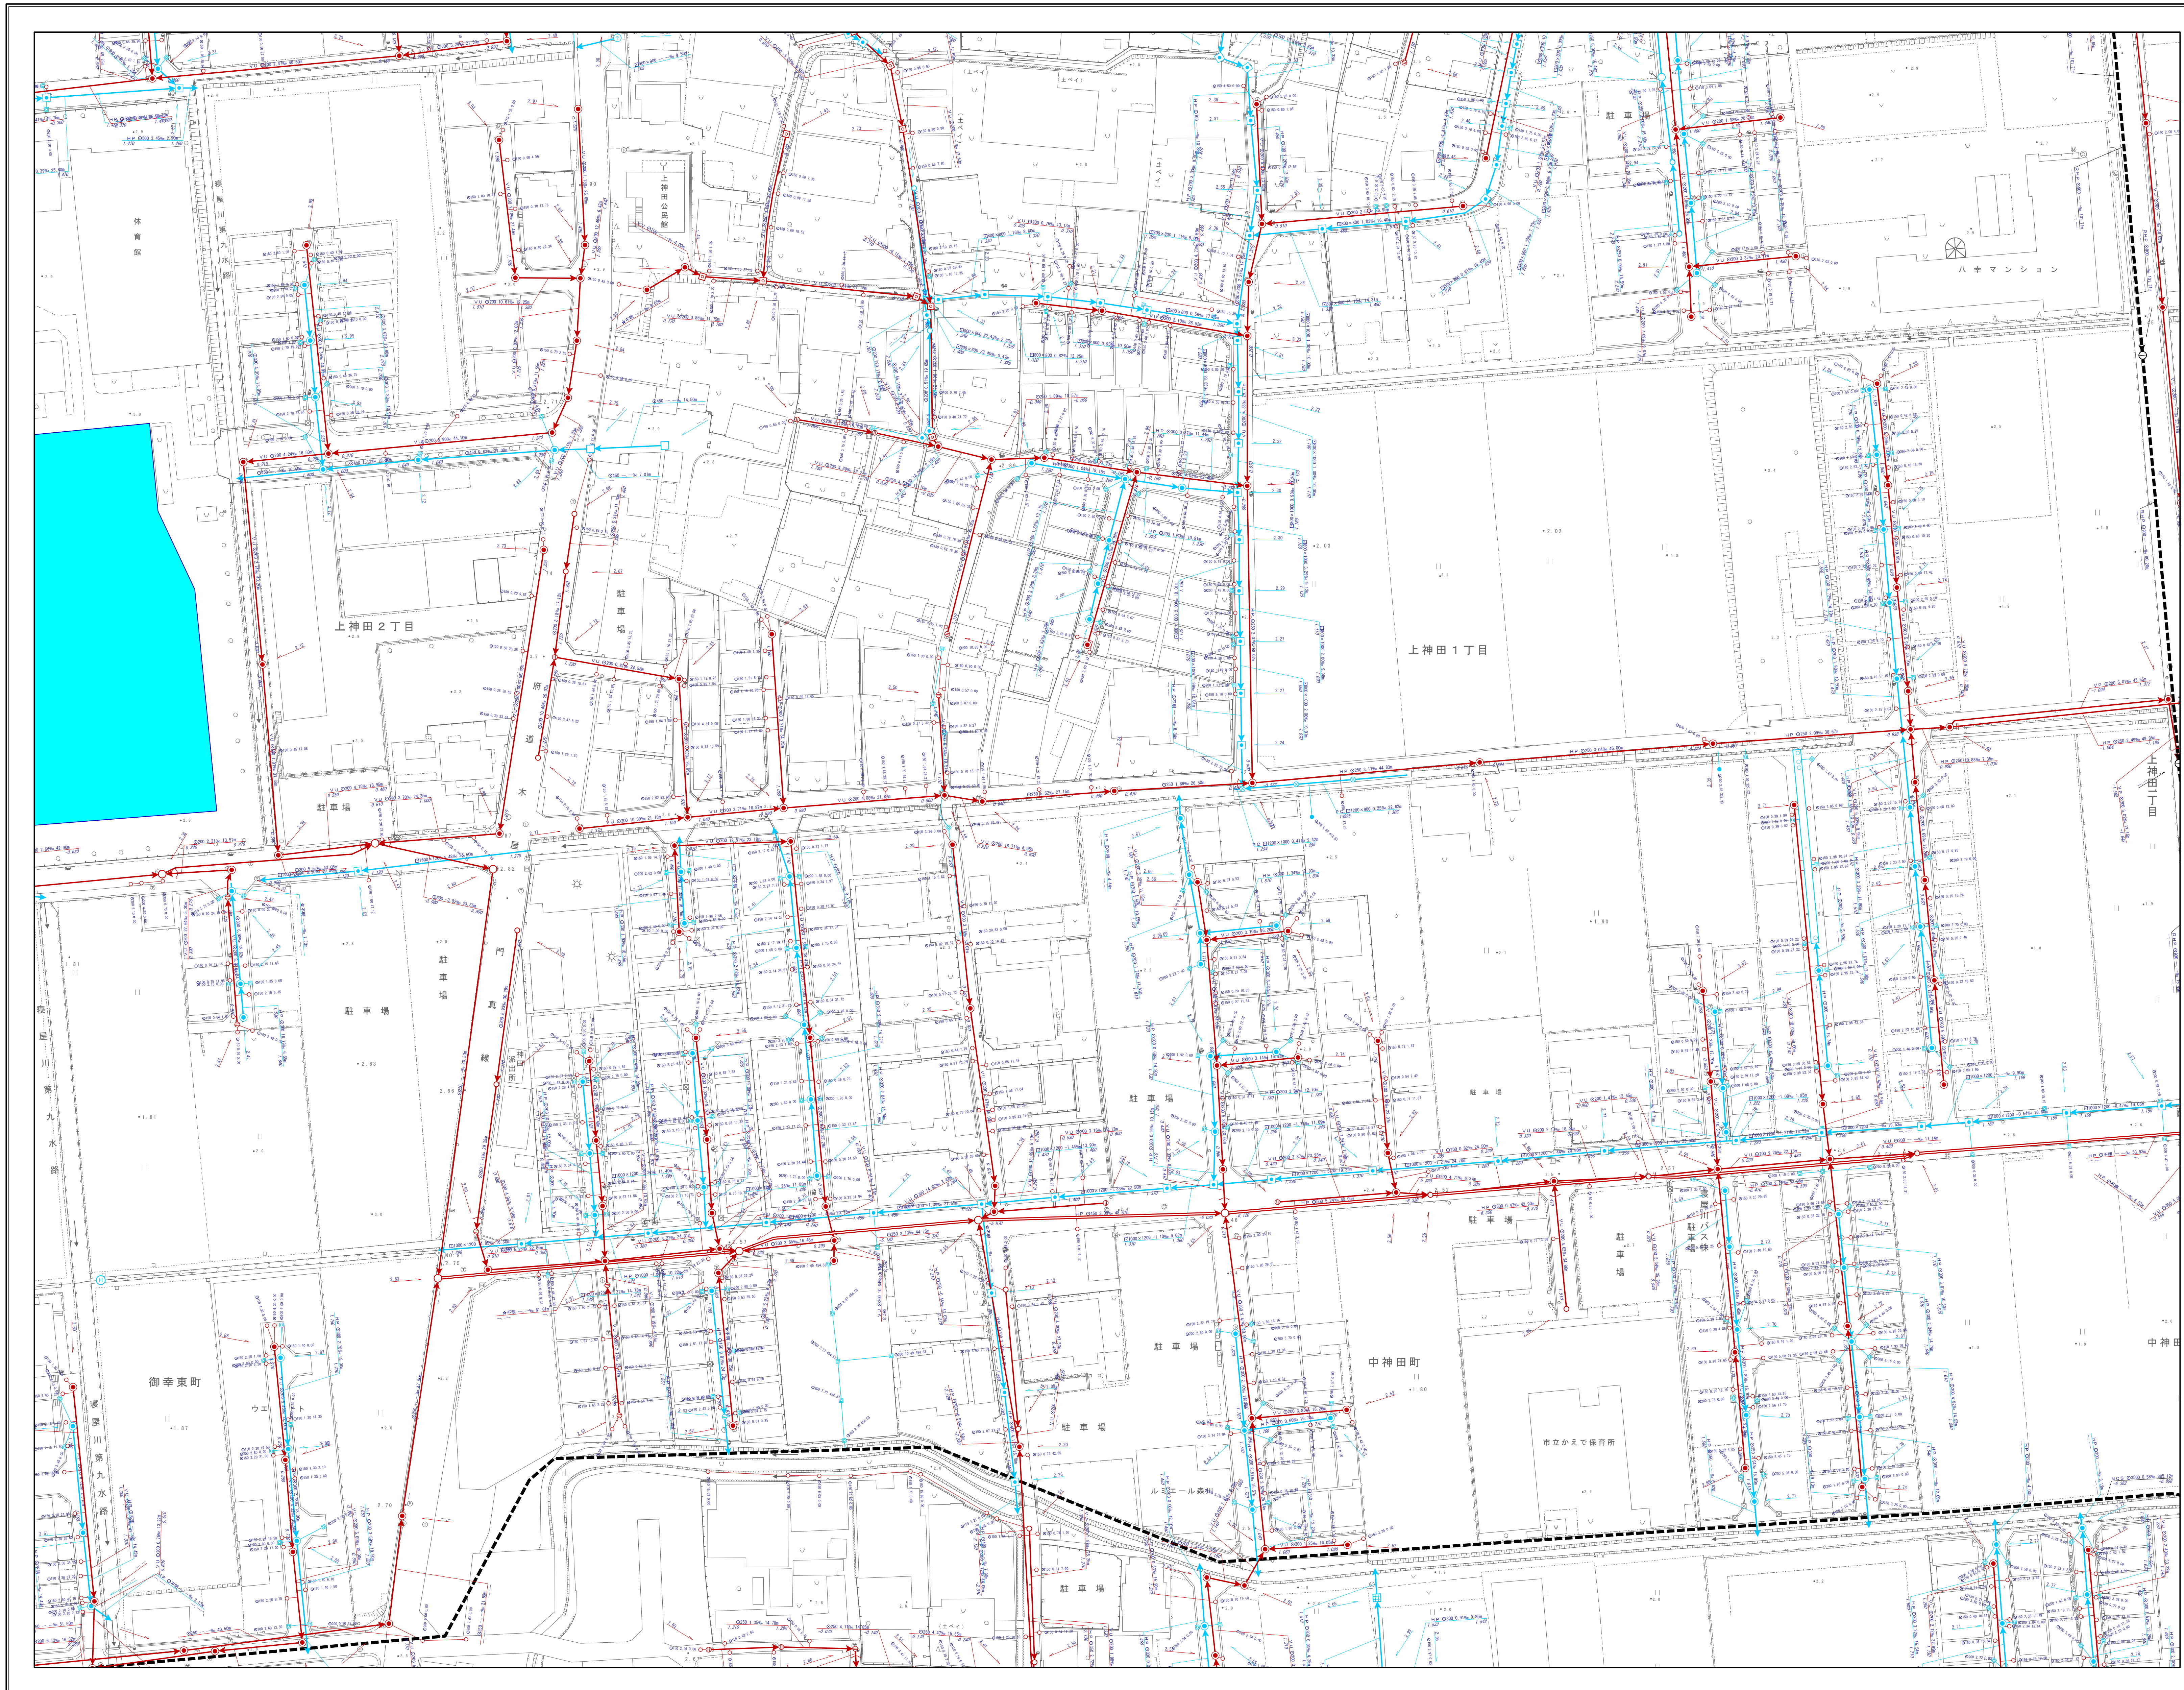

凡		例	
記号		名称	
[Thick black arrow]		流域幹線	
[Red arrow]		幹線管渠	
[Thin red arrow]		枝線管渠	
[Red arrow]		汚水	
[Blue arrow]		雨水	
[Green arrow]		合流	
[Red arrow with circle]		副管	
人 孔			
[Circle with Y]	Y号人孔	[Circle with 0]	0号人孔
[Circle with 1]	1号人孔	[Circle with 1]	橋田人孔
[Circle with 2]	2号人孔	[Small circle]	小口人孔
[Circle with 3]	3号人孔	[Circle with 3]	塩ビ30人孔
[Circle with 4]	4号人孔	[Circle with 4]	コンφ45人孔
[Circle with 5]	5号人孔	[Circle with 5]	レジン人孔
[Circle with 6]	6号人孔	[Circle with P0]	マンホールポンプ 0号人孔
[Circle with 7]	7号人孔	[Circle with P1]	マンホールポンプ 1号人孔
[Circle with 1]	特1号人孔	[Circle with P2]	マンホールポンプ 2号人孔
[Circle with 2]	特2号人孔	[Circle with P3]	マンホールポンプ 3号人孔
[Circle with 3]	特3号人孔	[Circle with P4]	マンホールポンプ 4号人孔
[Circle with 4]	特4号人孔	[Circle with P]	マンホールポンプ 特殊人孔
[Square]	矩形人孔	[Circle with P]	マンホールポンプ 人孔種別不明
[Triangle]	特殊人孔	[Square with P]	ポンプ場
[Square with X]	伏越人孔	[Triangle]	吐け口
[Circle with 500]	φ500特殊人孔	[Vertical line]	キャップ止め
[Circle with 600]	φ600特殊人孔	[Dot]	吐け口
[Circle with 750]	φ750特殊人孔	[Circle with X]	ダミー人孔
[Grid]	会所	[Circle with ?]	不明
雨 水 施 設			
[Circle with H]	樋門	[Blue square]	調節池
ま す			
[Red line with circle]	汚水樹	[Blue line with circle]	雨水樹
[Blue line with square]	道路雨水樹	[Red line with circle]	ポンプ
[Red line with T]	キャップ止	[Red line with circle]	不明
人 孔 属 性			
[Circle]	地盤高	111.110	
管 渠 属 性			
[Red line]	管断面 勾配	管種 ↓ 管径 ↓ 区間距離	
[Red line]	VU Q200 0.48% 20.75m		
[Red line]	上流管底高	4.230	下流管底高
[Red line]	管断面 勾配	管種 ↓ 管径 ↓ 区間距離	
[Red line]	VU Q200 0.48% 20.75m		
[Red line]	上流管底高	4.230	下流管底高
[Red line]	4.220		
取 付 管 属 性			
[Red line]	管断面	取付管延長	
[Red line]	φ100 4.29	10.84	
[Red line]	管径	上流側人孔からの距離	