
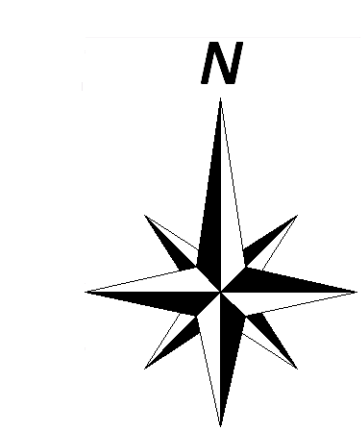


寝屋川市下水道台帳

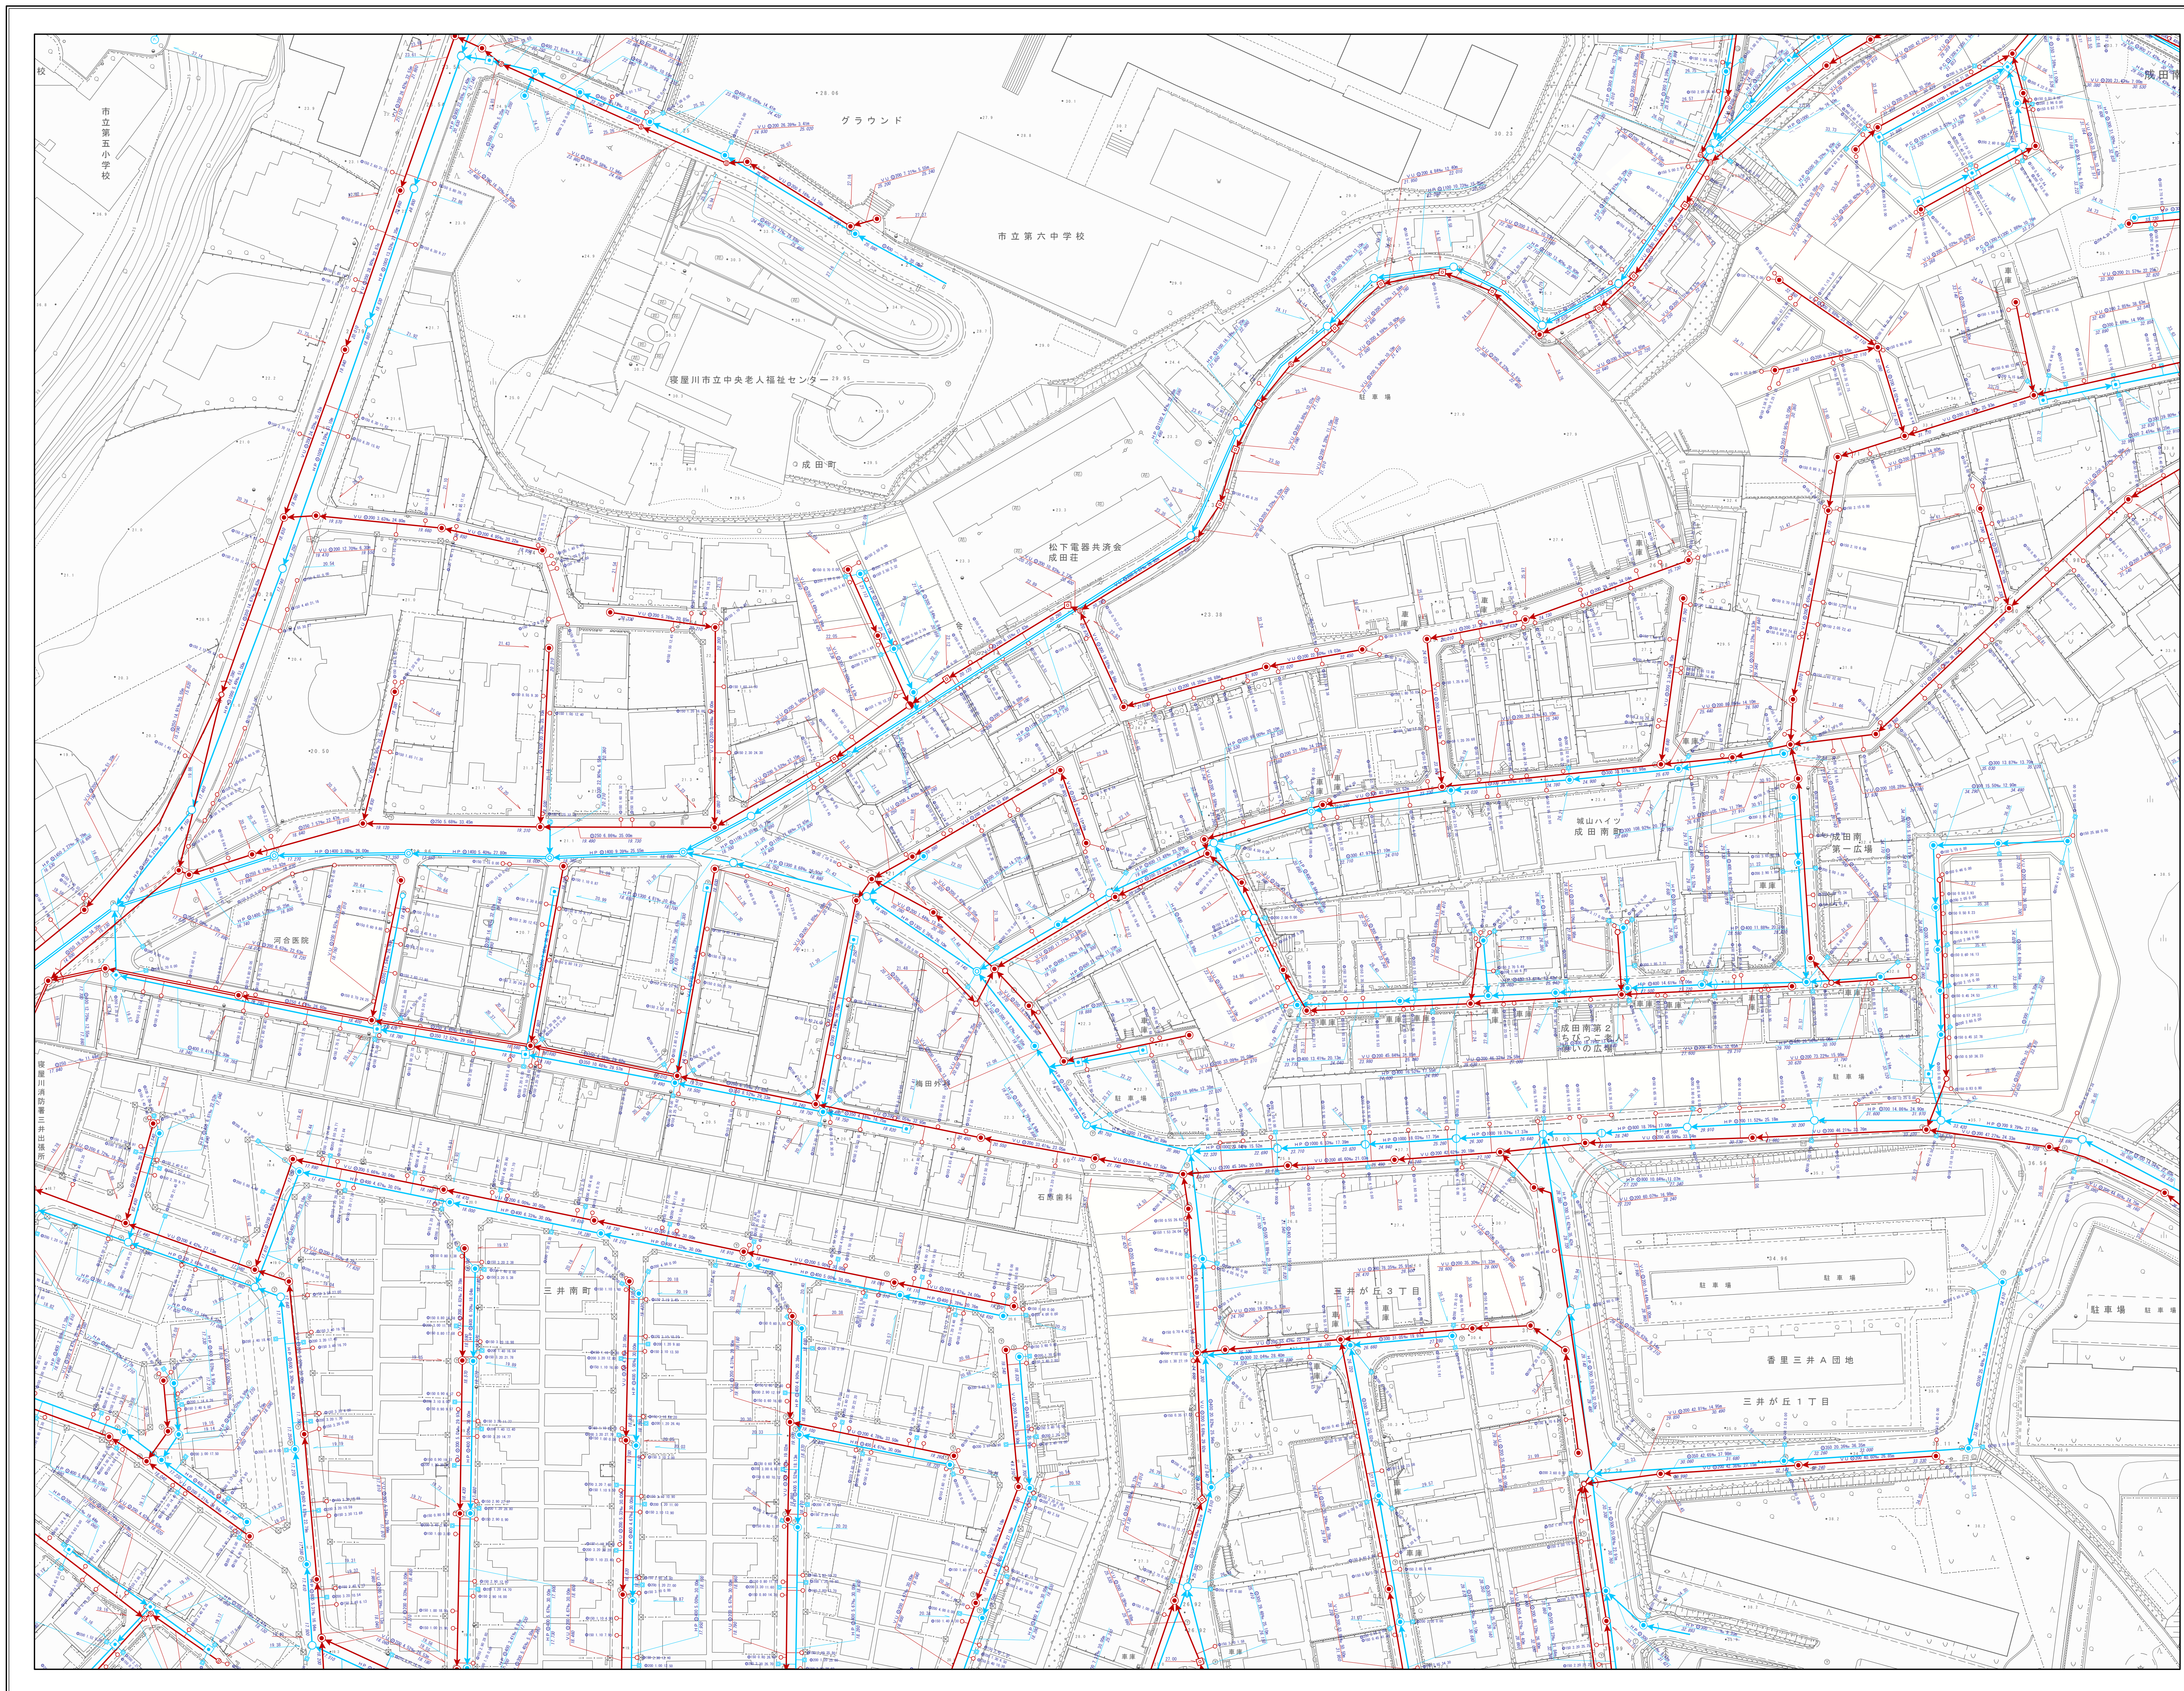

| 凡 | | 例 | |
|-------------------------|---|-------------------------|--------------------|
| 記号 | | 名称 | |
| [Thick black arrow] | | 流域幹線 | |
| [Red arrow] | | 幹線管渠 | |
| [Thin red arrow] | | 枝線管渠 | |
| [Red arrow] | | 汚水 | |
| [Blue arrow] | | 雨水 | |
| [Green arrow] | | 合流 | |
| [Red arrow with circle] | | 副管 | |
| 人 孔 | | | |
| [Circle with Y] | Y号人孔 | [Circle with 0] | 0号人孔 |
| [Circle with 1] | 1号人孔 | [Circle with 1] | 橋田人孔 |
| [Circle with 2] | 2号人孔 | [Small circle] | 小口人孔 |
| [Circle with 3] | 3号人孔 | [Circle with 30] | 塩ビ30人孔 |
| [Circle with 4] | 4号人孔 | [Circle with 45] | コンφ45人孔 |
| [Circle with 5] | 5号人孔 | [Circle with L] | レジン人孔 |
| [Circle with 6] | 6号人孔 | [Circle with P0] | マンホールポンプ 0号人孔 |
| [Circle with 7] | 7号人孔 | [Circle with P1] | マンホールポンプ 1号人孔 |
| [Circle with 特1] | 特1号人孔 | [Circle with P2] | マンホールポンプ 2号人孔 |
| [Circle with 特2] | 特2号人孔 | [Circle with P3] | マンホールポンプ 3号人孔 |
| [Circle with 特3] | 特3号人孔 | [Circle with P4] | マンホールポンプ 4号人孔 |
| [Circle with 特4] | 特4号人孔 | [Circle with P] | マンホールポンプ 特殊人孔 |
| [Circle with square] | 矩形人孔 | [Circle with P] | マンホールポンプ 人孔種別不明 |
| [Circle with house] | 特殊人孔 | [Square with P] | ポンプ場 |
| [Circle with X] | 伏越人孔 | [Triangle with P] | 吐け口 |
| [Circle with phi 500] | φ500特殊人孔 | [Vertical line] | キャップ止め |
| [Circle with phi 600] | φ600特殊人孔 | [Dot] | 吐け口 |
| [Circle with phi 750] | φ750特殊人孔 | [Circle with X] | ダミー人孔 |
| [Square with grid] | 会所 | [Circle with ?] | 不明 |
| 雨 水 施 設 | | | |
| [Circle with H] | 樋門 | [Blue square] | 調節池 |
| ま す | | | |
| [Red line with circle] | 汚水樹 | [Blue line with circle] | 雨水樹 |
| [Blue line with square] | 道路雨水樹 | [Red line with circle] | ポンプ |
| [Red line with T] | キャップ止 | [Red line with circle] | 不明 |
| 人 孔 属 性 | | | |
| [Circle with 111.110] | 地盤高 111.110 | | |
| 管 渠 属 性 | | | |
| [Diagram 1] | 管断面 勾配 管種 ↓ 管径 ↓ 区間距離 VU Q200 0.48% 20.75m 上流管底高 4.230 下流管底高 4.220 | | |
| [Diagram 2] | 管断面 勾配 管種 ↓ 管径 ↓ 区間距離 VU Q200 0.48% 20.75m 上流管底高 4.230 下流管底高 4.220 | | |
| 取 付 管 属 性 | | | |
| [Diagram] | 管断面 取付管延長 管径 ↓ 管径 ↓ 上流側人孔からの距離 100 4.29 10.04 | | |